
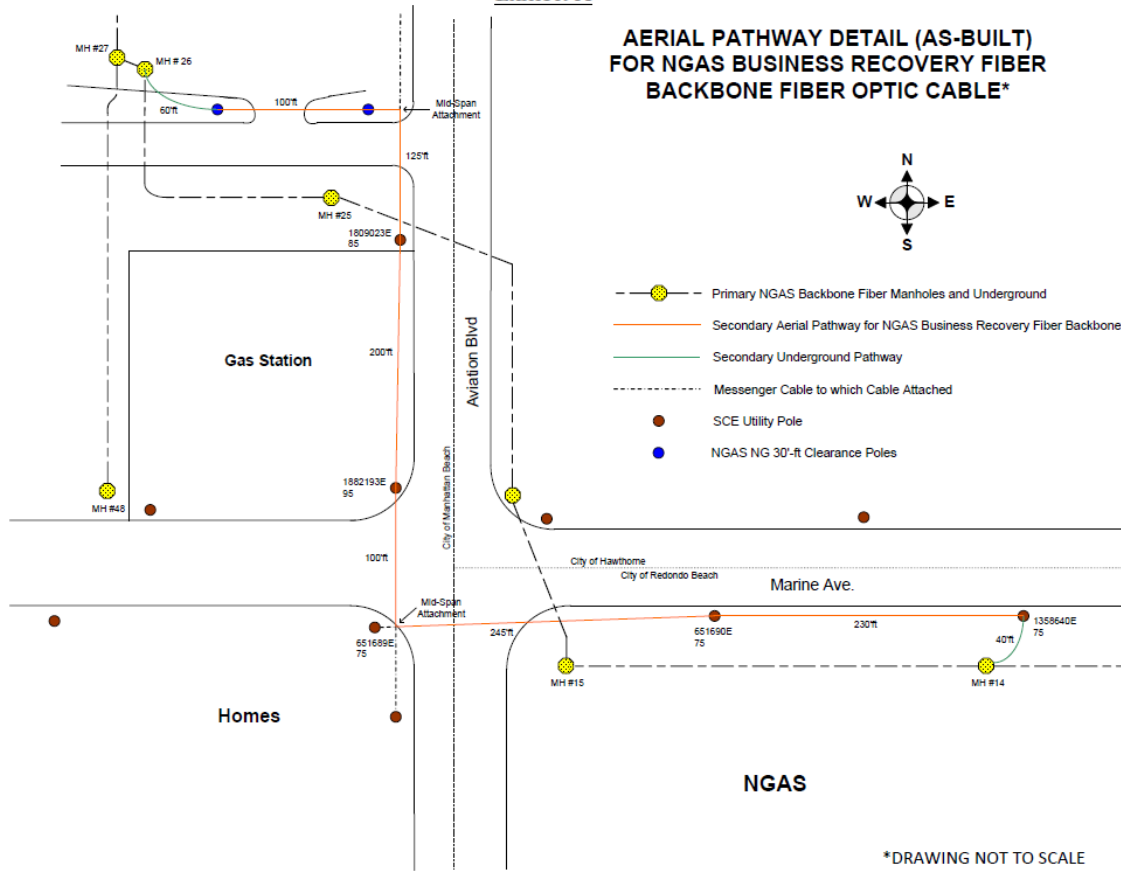


Exhibit A

**AERIAL PATHWAY DETAIL (AS-BUILT)
FOR NGAS BUSINESS RECOVERY FIBER
BACKBONE FIBER OPTIC CABLE***

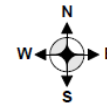

*DRAWING NOT TO SCALE

Backup Comm on Utility Poles_v3.vsd